



1. THIS ONSITE WASTEWATER TREATMENT SYSTEM (OWTS) RECORD DRAWING IS FROM ONSITE SURFACE OBSERVATIONS ONLY. ITS INTENDED USE IS FOR APPROXIMATE LOCATIONS OF THE CONSTRUCTED OWTS AND IS NOT TO BE UTILIZED FOR ANY ADDITIONAL DESIGNS TO THIS OWTS.
2. THIS OWTS IS DESIGNED FOR A FOUR (4) BEDROOM HOME WITH 8 PEOPLE TOTAL OCCUPYING THE HOME.
3. THE OWTS RECORD DRAWING CONFIRMS THAT ALL SETBACKS REQUIRED BY CODE OR VARIANCE HAVE BEEN MET; THE FUTURE WELL AND DOMESTIC WATER PIPE MUST BE CONSTRUCTED WITHIN THE REQUIRED SETBACKS.
4. THIS SYSTEM WAS CONSTRUCTED BY WILL SANCHEZ GRAVEL & EXCAVATION. CONTACT WILL SANCHEZ AT 970-565-2178 OR EMAIL AT WILLSANEXC@YAHOO.COM.



P.O. BOX 234
COLORADO 81332
970-708-0326
INELANDCONSULTI

GREGG@ALPINELANDCONSULTING.COM

COWTS RECORD PLAN

CLIENT:

JUSTIN MEYER
JUSTIN@ROCKETSCIENCE.CO

DATE: SEPTEMBER 10, 2025



PROJECT #: 2018008

PROJECT MANAGER: GEA
DRAWN BY: JTV

SHEET #:

1 OF

THIS OWTS RECORD DRAWING WAS PREPARED BY ME AND UNDER MY DIRECT SUPERVISION ON BEHALF OF ALPINE LAND CONSULTING, LLC FOR JUSTIN MEYER AND INCLUDES OWTS RECORD DRAWING ONLY, AND DOES NOT INCLUDE ANY OTHER PLANNING OR ENGINEERING.

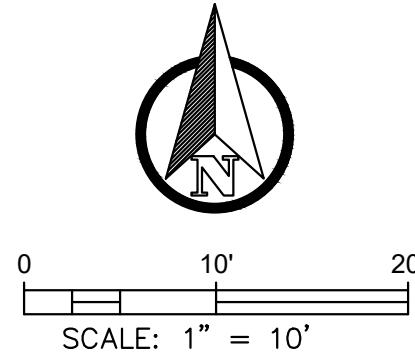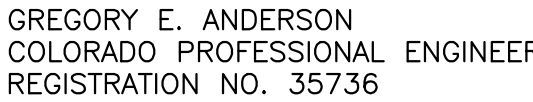

NO.	REVISIONS